


**TOWN OF DEDHAM  
AS-BUILT FORM**

**ADDRESS:** 1 EAST STREET  
**DATE:** 01/01/01

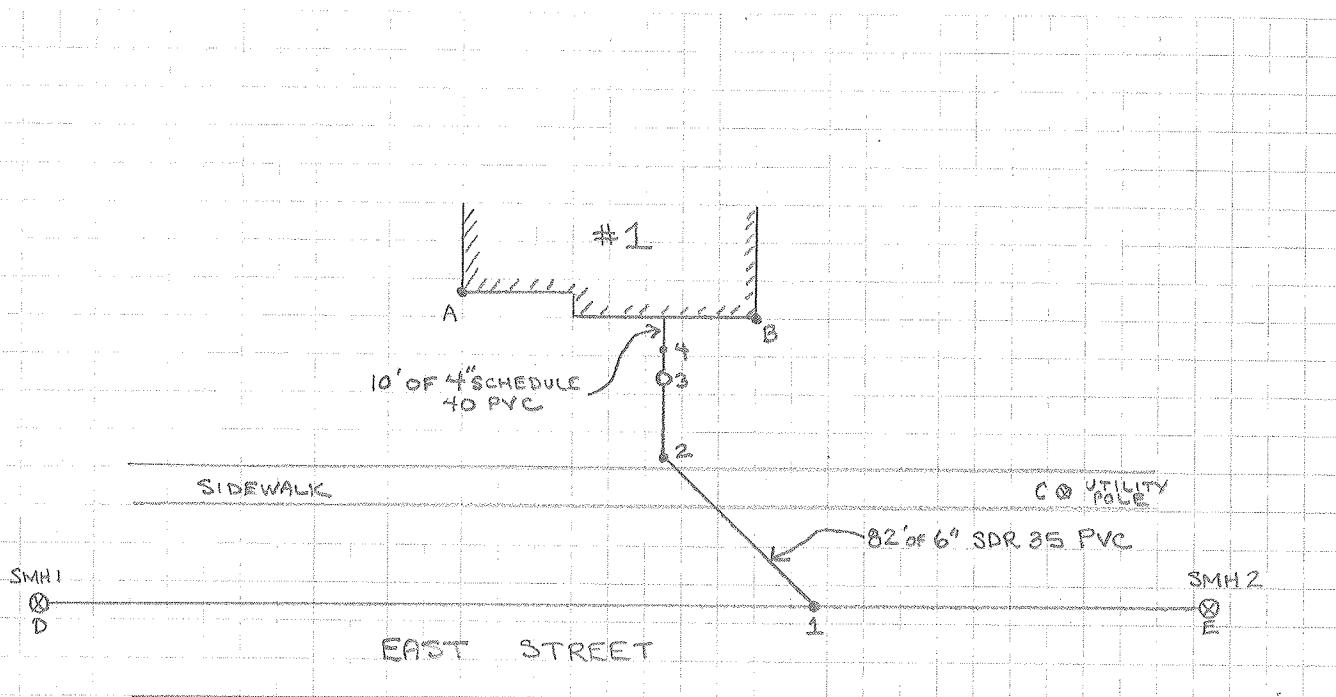

**LEGEND**

A & B - FOUNDATION CORNERS

C - UTILITY POLE

D - SMH 1

E - SMH 2

1 - SEWER MAIN CONNECTION

2 - 45° ELBOW

3 - 6" PVC SDR 35 CLEANOUT

4 - 4" x 6" FERNCO

**DISTANCE**

D → 1 = 80'

E → 1 = 35'

C → 1 = 30'

A → 2 = 28'

B → 2 = 21'

C → 2 = 44'

A → 3 = 22'

B → 3 = 16'

C → 3 = 39'

A → 4 = 18'

B → 4 = 13'

C → 4 = 43'

**EXAMPLE**

**NOTE:** The as-built shall show the sewer work performed and a minimum of three (3) swing ties to all applicable features: public sewer mainline connection, public sewer mainline disconnection, bends, cleanouts, shut off valve, pump chamber and fernco connections.